




FRONT ELEVATION

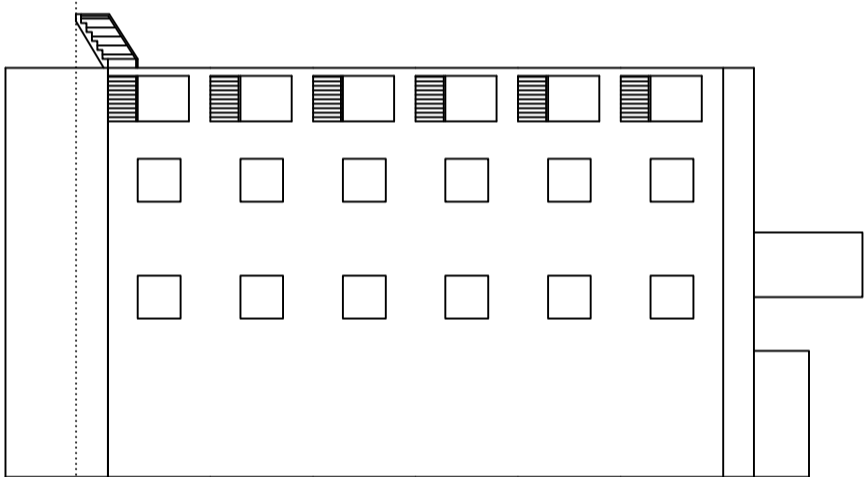



RIGHT SIDE ELEVATION

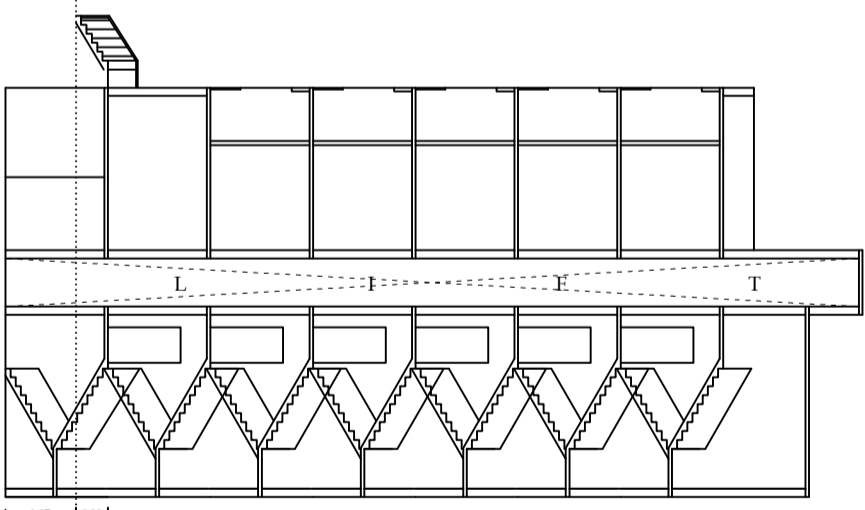

SECTION ON X-X

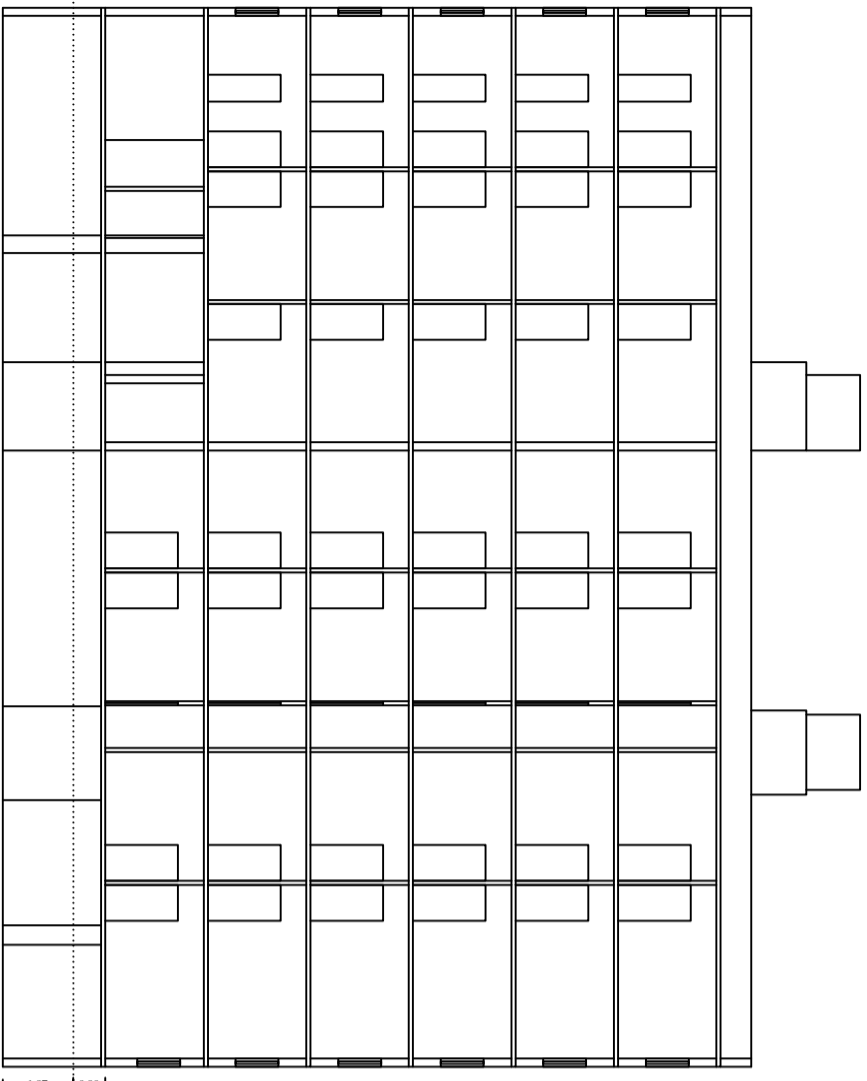

SECTION ON Y-Y

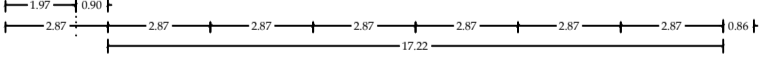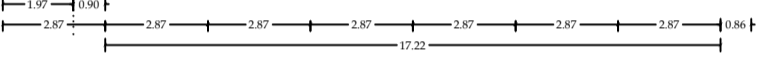

FOR DMILC USE

TITLE OF DRAWING

AS BUILT PLAN COMMERCIAL BUILDING OF
 (1) SRI. AWADH KISHORE S/O LATE SHITALA NANI
 LALLA (2) SMT. SAVITRI DEVI W/O SRI. AWADH SAHA
 (3) SRI. AMRENDRA KR. SAHAY (4) SRI. AMITESH KR
 SAHAY BOTH ARE S/O SRI. AWADH KISHORE SAHAY (5)
 SMT. POONAM SAHAY W/O SRI. AMRENDRA KR. SAHA
 (6) KUMARI SABITA SAHAY D/O SRI. AWADH KISHOR
 SAHAY (7) SRI. CHANDAN KR. LALA S/O LATE SURAJ
 NARAYAN LAL (8) SRI. PANKAJ KR. LAL (9) SRI. DEEPA
 KR. LAL BOTH ARE S/O LATE SHYAMA CHARAN LAL (10)
 SMT. RATNA CHAITRAJ W/O SRI. DHIRENDRA NATH
 CHAITRAJ OF ALL ARE HIRAPUR DHANBAD ON THE
 PART OF PLOT NO. 1107 KHATA NO. 109, MOUZ/
 HIRAPUR NO.07 IN THE DISTRICT OF DHANBAD
 (J H A R K H A N D)

SIGNATURE OF OWNER

SIGNATURE OF ENGINEER

PIYUSH KANTI SINGH
 (REGISTERED ENGINEER)
 Design, Survey & Value
 License No. DMV/ENR/003/2016