



by Sri Rajiv Ranjan Jha s/o Jai Nandan Jha
 s/o bmt. Alka Jha w/o Sri Alok Kumar Jha of
 Sumitra Apartment, Bekarbandh, Dhanbad
 Rep. by Attorney: Sri Alok Kumar Jha s/o
 Shubh Chandra Jha of Chauri Apartment
 Jharaidih P.S. & Dist. Dhanbad

Purchaser bmt. Babita Sharma w/o Sri Rajesh Kumar
 Sharma of Hari Navayan Nagar, Near Durgam
 Mandar, Barmasia, P.S. Dhanbad, Dist. Dhanbad

Schedule - mouza: Kola Husma No. 12. Khata No: 84. New
 Khata No: 580. Plot No: 1557 New Plot No: 1460 (P)
 Area: 3 Katha. order by 4.95 Dec.

Boundaries - North : 16'11"41" = 18'0" Road
 South : Plot No: 1556
 East : part of this plot. Vendor 112
 West : part of this plot. Vendor 112

shown in red

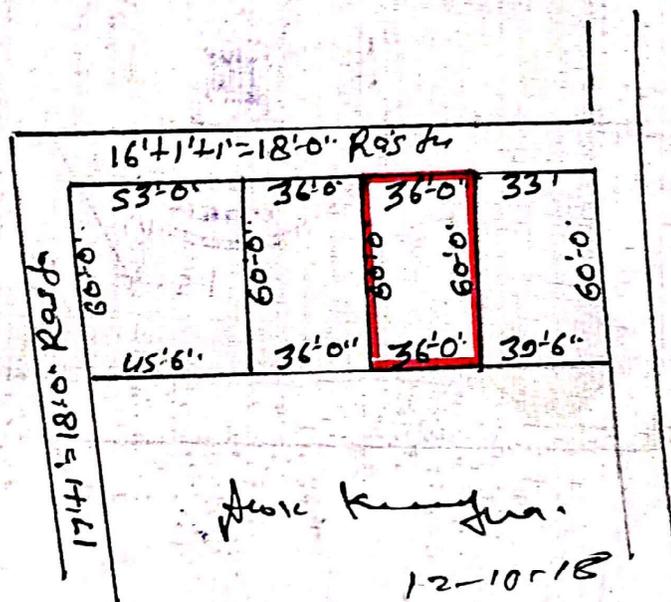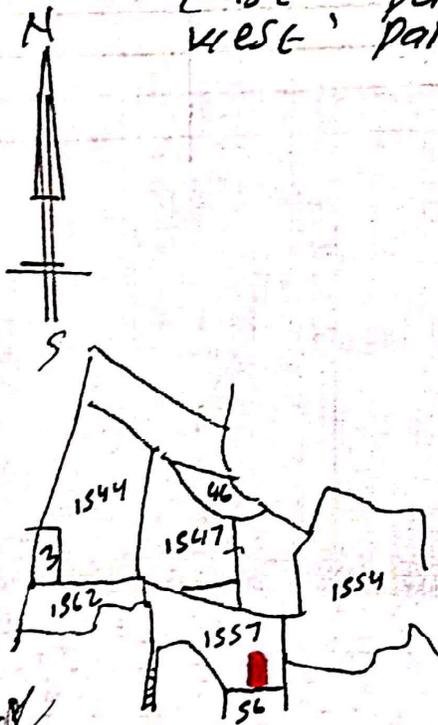

Babita Sharma
 12-10-18