

कार्यालय,
धनबाद नगर निगम, धनबाद।

Email - dhanbadmunicipalcorporationadm@gmail.com

(PMAY कोषांग)

पत्रांक/ध०न०नि०,

प्रेषक,

नगर आयुक्त,
धनबाद।

सेवा में,

निदेशक,
नगरीय प्रशासन निदेशालय,
नगर विकास एवं आवास विभाग,
झारखण्ड सरकार, रांची।

धनबाद, दिनांक.....

विषय :- प्रधानमंत्री आवास योजना (शहरी) अंतर्गत घटक -III के आवास निर्माण के क्रियान्वयन के संबंध में।

महाशय,

उपर्युक्त विषय के संबंध में कहना है कि प्रधानमंत्री आवास योजना (शहरी) अंतर्गत घटक-III के आवास हेतु मौजा-बारामुड़ी, प्लॉट स०-280, कुल रकबा 3.80 एकड़ भूमि का Land Demarcation नगर निगम अमीन, CLTC, जुडको के अधिकारी एवं M/S NPCC के प्रतिनिधि के मौजूदगी में कराया गया है।

सादर सूचनार्थ एवं आवश्यक कार्यवाई हेतु प्रेषित।

अनुलग्नक :- यथोक्त

विश्वासभाजन

ह०

नगर आयुक्त,
धनबाद।

प्रतिलिपि :- ज्ञापांक...../ध.न.नि., दिनांक.....
परियोजना निदेशक (तकनीकी) जुडको लिमिटेड, रांची को सूचनार्थ एवं आवश्यक कार्यवाई हेतु प्रेषित।


ह०

नगर आयुक्त,
धनबाद।

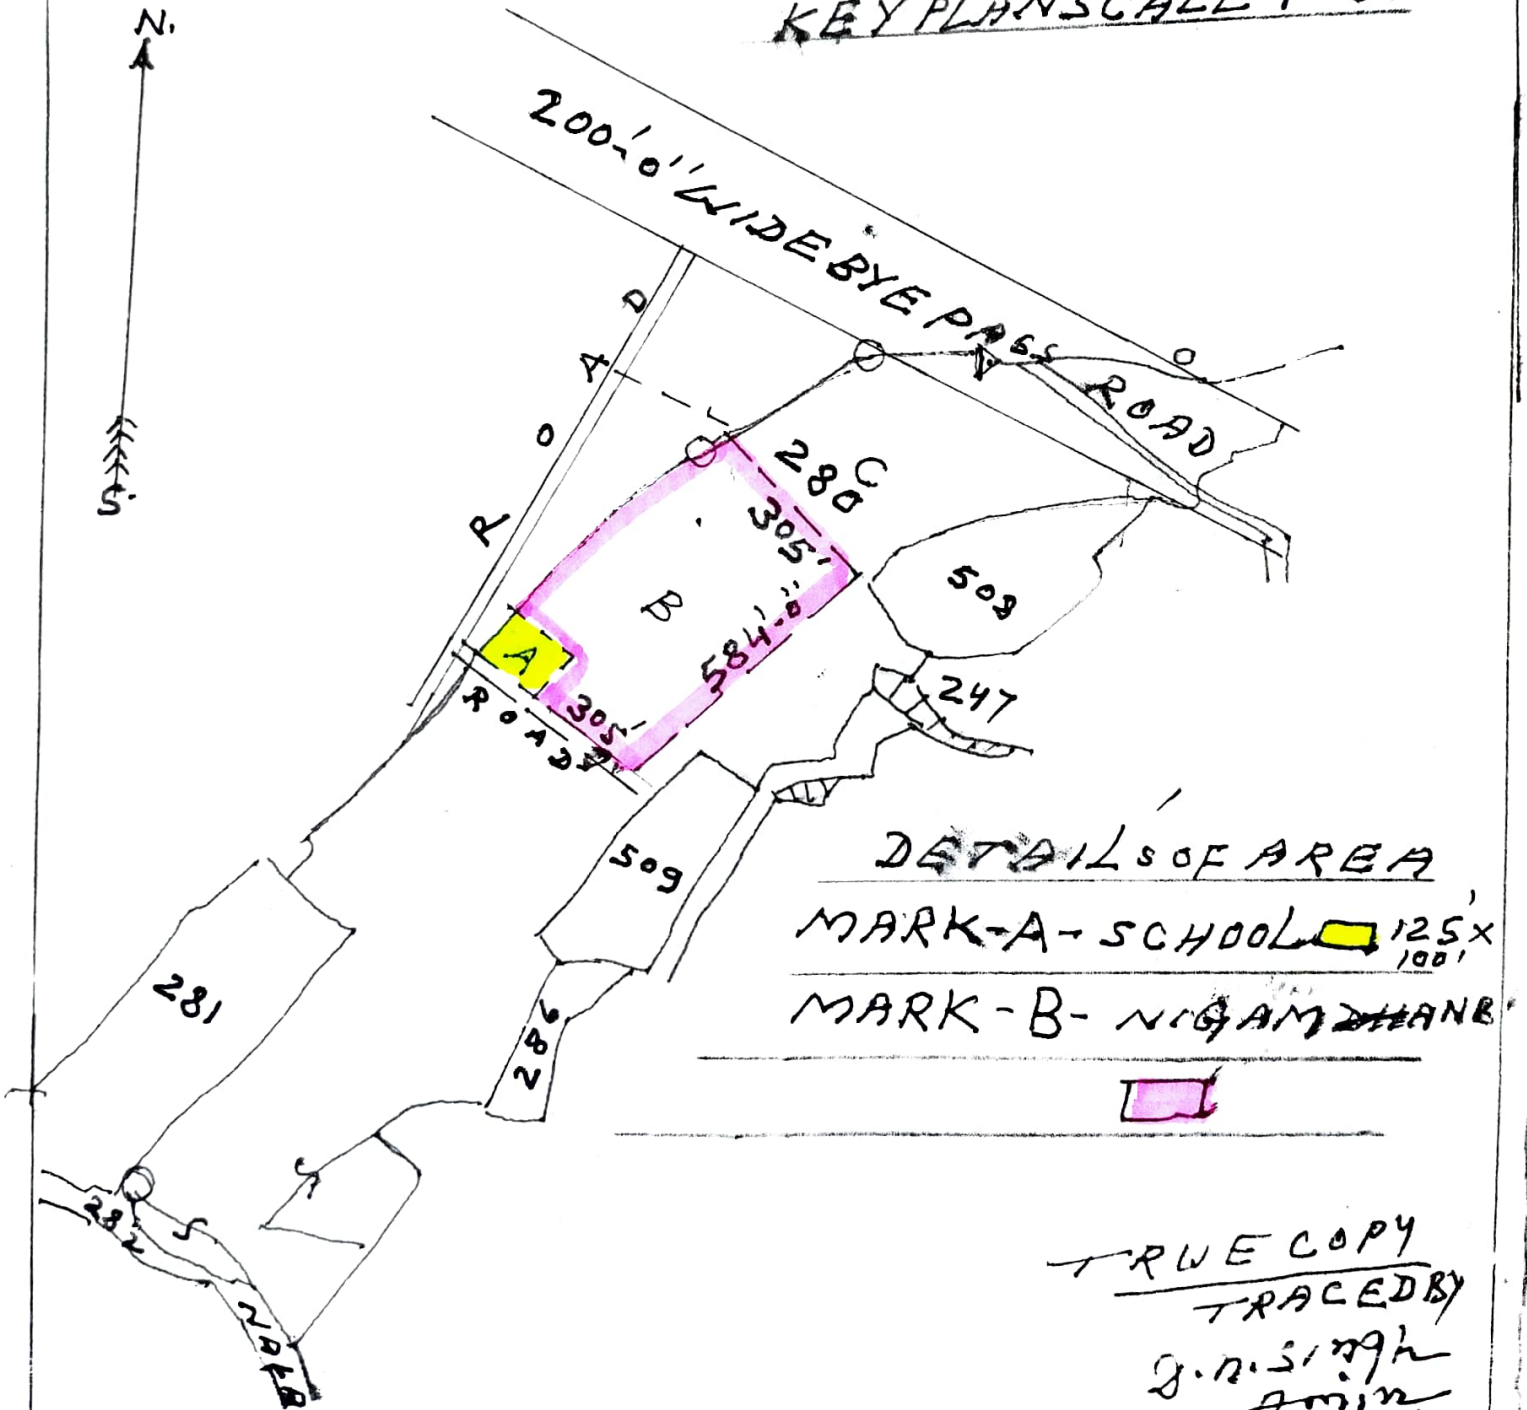
प्रतिलिपि :- सचिव, नगर विकास एवं आवास विभाग, झारखण्ड सरकार, रांची को सादर सूचनार्थ समर्पित।



ज्ञापांक 2096 /ध.न.नि., दिनांक 11/10/2021

नगर आयुक्त,
धनबाद।

LAND IS SITUATED IN MOUZA - BAROMURI,
P.S. NO. 3 THANA - JHARIA AT PRESENT DHANBAD
GAIRABAD KHATA NO. 42 PLOT NO. 280 FULL
PLOT OF AREA 18.18 ACRE. OUT OF AREA 3.80 -
ACRE PLOT OF DHANBAD NAGAR NIGAM DHANB
MARK - B SHOWN IN RED ROSE COLOUR 

KEY PLAN SCALE 1" = 330'-0"



DETAILS OF AREA
MARK-A - SCHOOL  125' x 100'
MARK-B - NIGAM DHANB 

TRUE COPY
TRACED BY
J. N. Singh
Amin
N. Dhanbad
11/10/21