
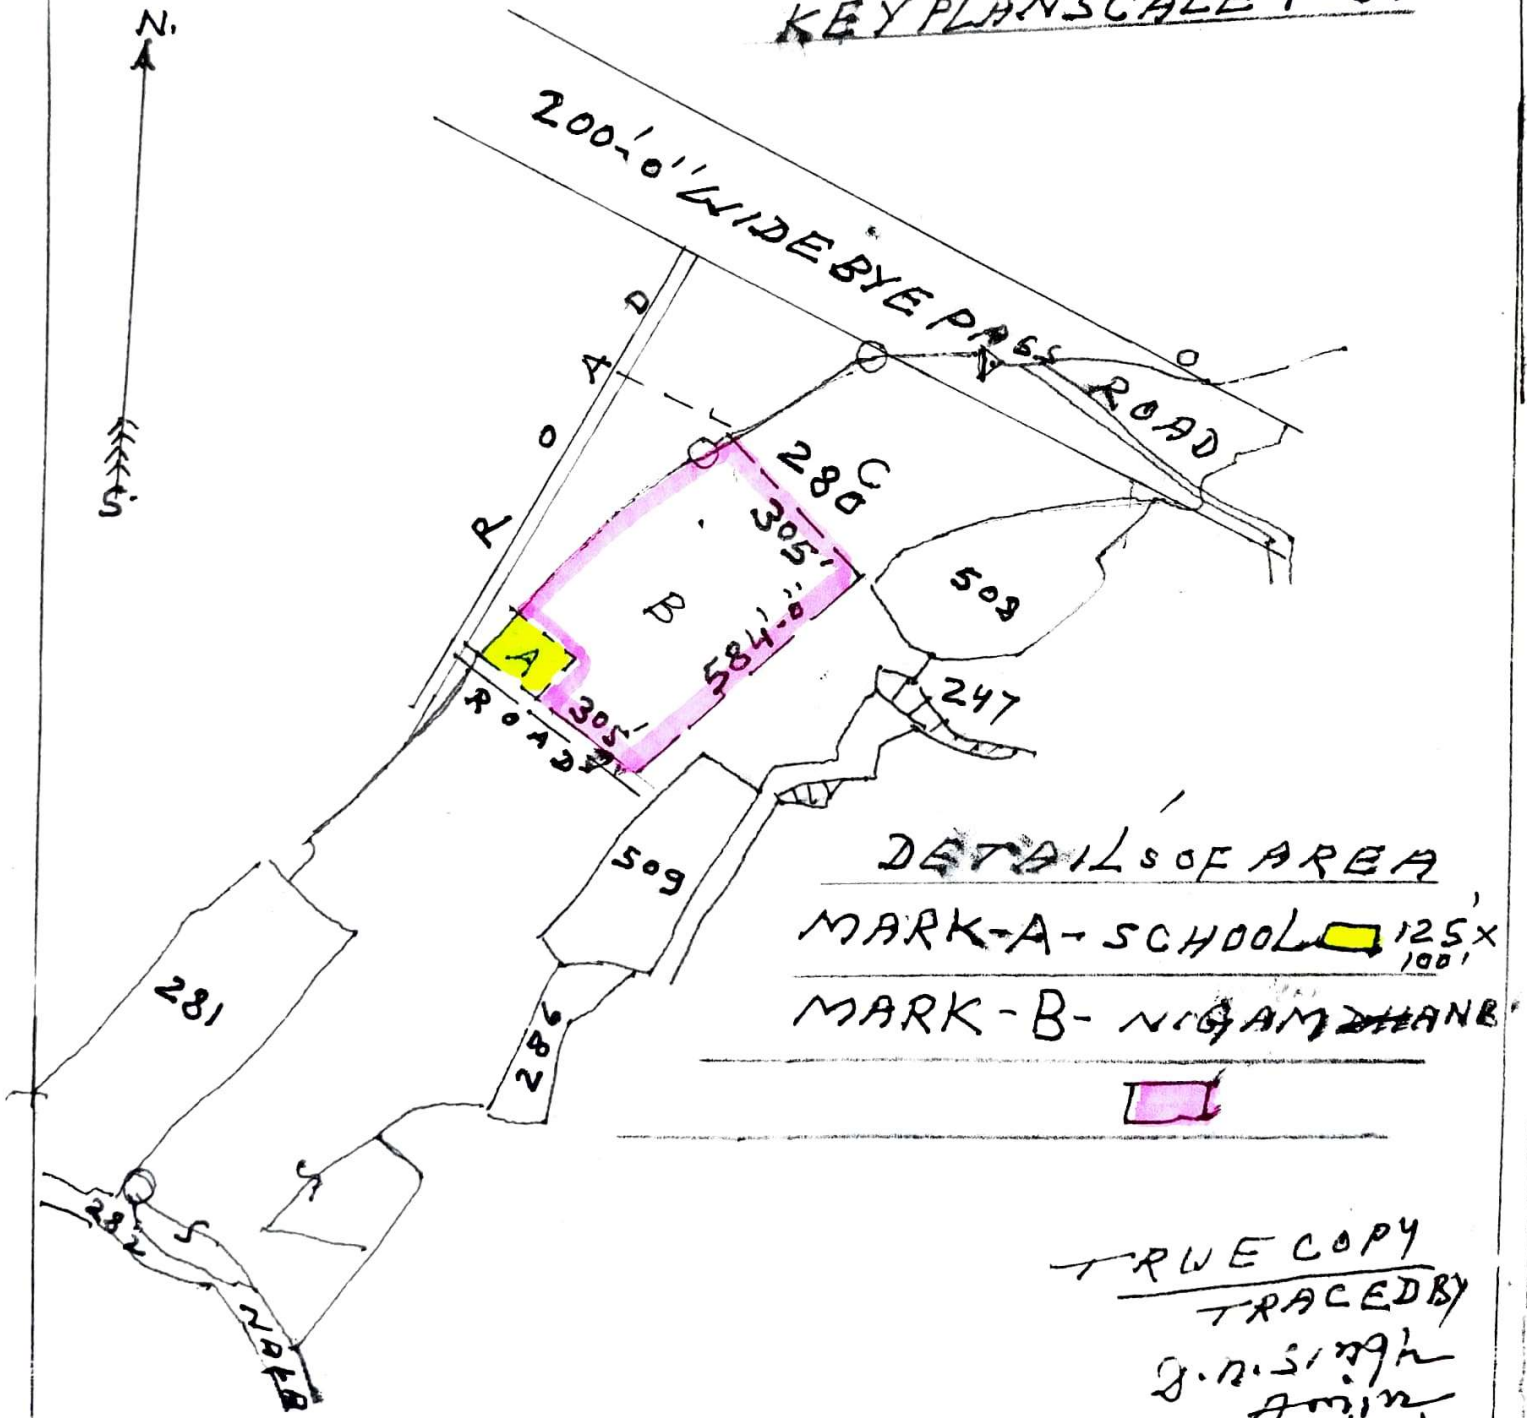




LAND IS SITUATED IN MOUZA - BAROMURI,  
P.S. NO. 3 THANA - JHARIA AT PRESENT DHANBAD  
GAIRABAD KHATA NO. 42 PLOT NO. 280 FULL  
PLOT OF AREA 18.18 ACRE. OUT OF AREA 3.80 -  
ACRE A LOT OF DHANBAD NAGAR NIGAM DHANB  
MARK - B SHOWN IN RED ROSE COLOUR 

KEY PLAN SCALE 1" = 330' - 0"



DETAILS OF AREA  
MARK - A - SCHOOL  125' x 100'  
MARK - B - NIGAM DHANB 

TRUE COPY  
TRACED BY  
J. N. Singh  
Amin  
N. Dhanbad  
11/10/21