

1161

Ranchi Industrial Area Development Authority  
"RIADA Bhawan" (2nd Floor) Main Road, Ranchi.

No. 620 / RIADA, Dated 15/3/89 1989

Possession of Plot No./~~Spec~~ No. A..... (Area 1.00 Hect.)  
Allotted to M/s MIMEC ENGINEERS.....  
Wide RIADA Order Contained with Memo No. 2376 Dated 11.9.86  
In the NANKUM RANCHI... Industrial Area/Estate have been  
taken/handed Over to M/s. MIMEC ENGINEERS.....  
..... on 25.1.89..... as per Plan enclosed.

Certified that ~~the~~ Vacant Possession has been  
taken ~~from~~ from any encroachment.

*Handover*  
*15/3/89*  
*part*

Taken Over by:

Handed Over by:

*H. C. Singh*  
*15/3/89*

I. E. O.

*G. K. Singh*  
*15/3/89*  
Area Incharge

Development Officer.

Memo No. 620 / RIADA, Ranchi, Dated 15/3/89

Copy forwarded to I. E. O. Unit Officer, Tupudana/  
Jr. Tech. Manager, I. E. Daltonganj, Palasou/Incharge, I. E. Jurtialiya  
and Dy. Dev. Officer (C), RIADA, Ranchi for information..

*V. S. Singh*  
*15.3.89*

Development Officer  
RIADA, Ranchi.


PLAN SHOWING THE LAND ALLOTTED TO M/S MIMEC ENGINEERS IN THE INDUSTRIAL AREA NAMKUM RANCHI IND. PLOT NO. VIDE RIADA ORDER NO. 23764/090 DATED 11-9-89

MEASUREMENTS IN THE PLAN : 1:00 (ACRE)

(69)



REFERENCE:-  
IND. PLOT  
ALLOTTED PLOT NO.

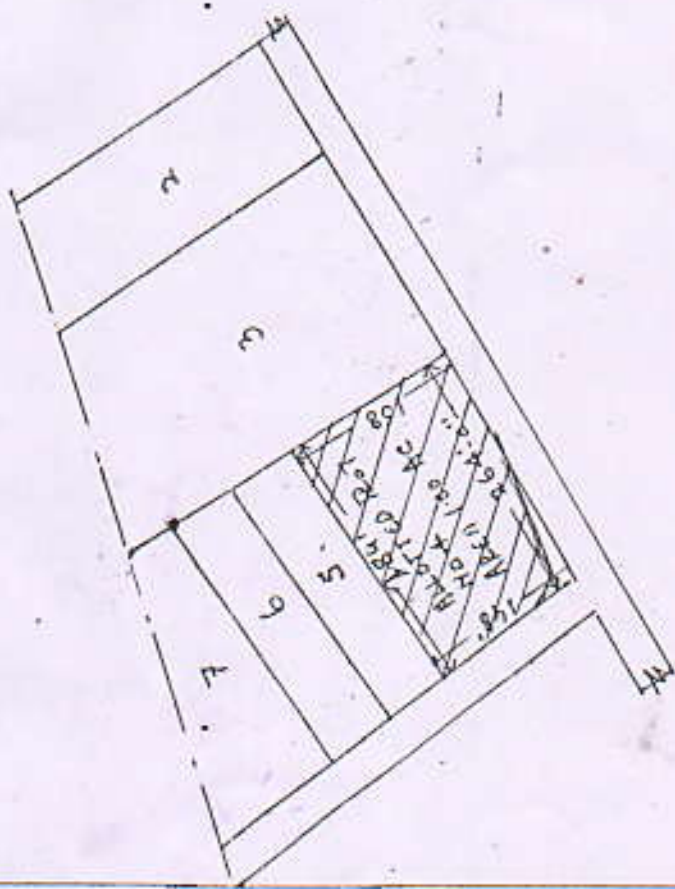

SCALE 1"=165'-0"

RANCHI INDUSTRIAL AREA DEVELOPMENT AUTHORITY

LAND POSSESSION MAP

|                                     |                                                         |
|-------------------------------------|---------------------------------------------------------|
| TAKEN OVER                          | HANDED OVER                                             |
| <br>M/S MIMEC ENGINEERS<br>15/12/89 | <br>Dy-DEV OFFICER<br>R.I.A.D.A. R.I.A.D.A.<br>15/12/89 |

Prepared by:-  
H. S. 2.89

*[Handwritten signature]*