

**Ranchi industrial Area Development Authority**  
**RIADA BHAWAN, Namkum Industrial Area, Lowadih, Ranchi.**

No..833/RIADA

Dated 30-5-2017

**PHYSICAL POSSESSION CERTIFICATE**

This is to certify that in compliance of order No.804 dated 26.05.2017 for giving physical possession of plot I, Mukesh Kumar Sr. I.E.O. of the Authority in presence of Dilip Kumar, I.E.O. and R.N. Sahu, Surveyor hand over physical possession of Shed No.23/A & 24/A, TUPUDANA INDUSTRIAL AREA to the allottee unit to M/s SUPER CAST, represented by Shri Dig Vijay Pradhan & Shri Kaushal Pradhan, Partner on this the ~~27~~ day of May, 2017 at Tupudana Industrial Area, Ranchi.

*Affix photograph of  
officials of Authority*




I, Shri Dig Vijay Pradhan & Shri Kaushal Pradhan, Shed No.23/A & 24/A Partner of M/s. SUPER CAST, received physical possession of land-Village-Pugru, Thana- Ranchi, Thana No.250, Dist- Ranchi, Khata No.18,74 Survey Plot No.339P,340P Area-0.314Acre land from Mukesh Kumar Sr. I.E.O. of the authority in the presence of Dilip Kumar, I.E.O. and R.N. Sahu, Surveyor on this the ~~27~~ day of May, 2017 at Ranchi.

  
Surveyor  
RIADA




  
I.E.O.  
RIADA

  
Dev. Officer  
RIADA

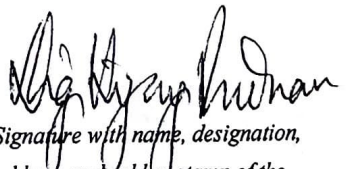  
Signature with name, designation,  
address and rubber stamp of the  
representative of the unit

PLAN SHOWING THE SHED ALLOTTED TO M/S SUPER CAST IN THE INDUSTRIAL AREA TUPUDANA, RANCHI. ALLOTTED INDUSTRIAL SHED NO. 23/A & 24/A WIDE RIADA ORDER NO. 115 DATED: 08.02.2017

REFERENCE

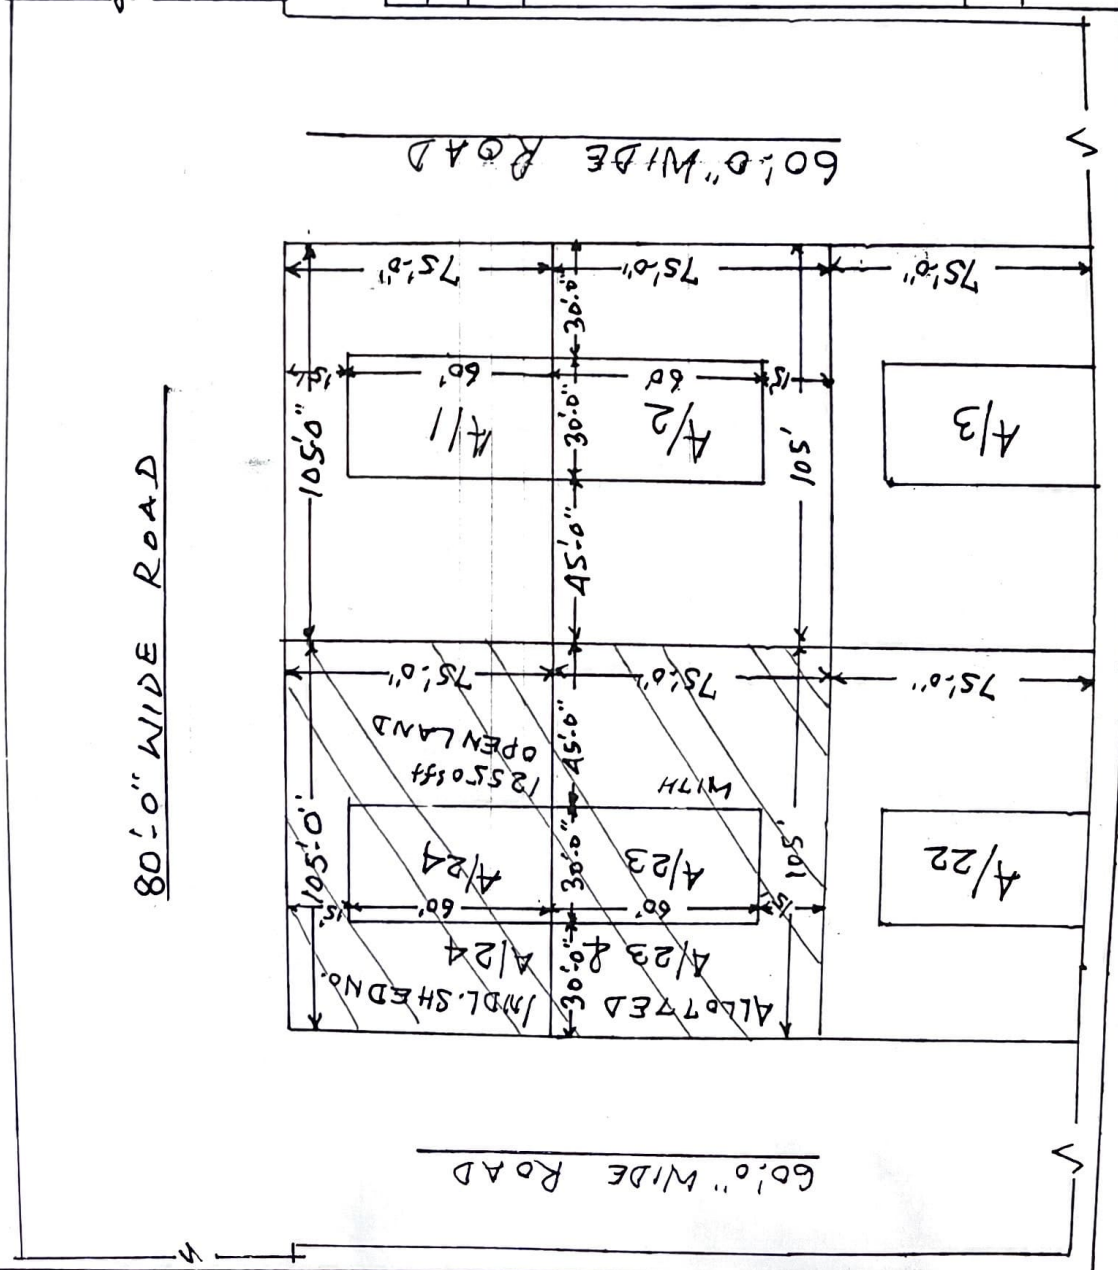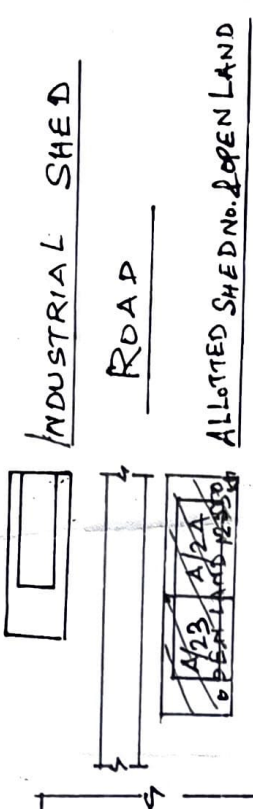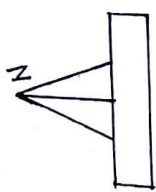

SCALE: 1" = 50'0"  
 RANCHI INDUSTRIAL AREA DEVELOPMENT AUTHORITY  
 SHED POSSESSION MAP

|                       |                            |
|-----------------------|----------------------------|
| TAKEN OVER            | HANDED OVER                |
| <i>Sgt. [unclear]</i> |                            |
| M/S SUPER CAST        | I.E.O.<br>R.1.A.D.A.       |
|                       | DEV. OFFICER<br>R.1.A.D.A. |

SURVEYOR: *[Signature]*