

Ranchi Industrial Area Development Authority
"RIADA Bhawan", Main Road, Ranchi

No. 706..

Dated 22/2/2000

Possession of Plot No. ~~Sheet~~ No. 265P. (Area 20000 SFT.....)

allotted to M/s. MODERN LEAF PRODUCTS... vide RIADA Order ^{A UNIT OF PRADHAN BROTHERS PVT}

contained with Memo No. 705..... Dated 22.2.2000 in the

TUPUDANA, RANCHI Industrial Area/Estate have been taken/ Handed over to
M/s. MODERN LEAF PRODUCTS on 22.2.2000... as per plan
enclosed.

Certified that the vacant possession has been taken free
from any encumbrance.

~~for President~~
Taken over by *S.K. Das*
Managing Director

Rud
Surveyor
I.E.O.


Handed over by
C. Das
Area Incharge

15


A UNIT OF PRADHAN BROTHERS P.L.D.

PLAN SHOWING THE LAND ALLOTTED TO M/S MODERN LEAF PRODUCTS
 IN THE INDUSTRIAL AREA TUPUDANA, RANCHI. ALLOTTED PLOT NO. 265 P
 BESIDE RANCHI-KHUNTI ROAD AREA. 20000 SFT. VIDERIADA ORDER
 NO 705 DATED 22.2.2000

(16)

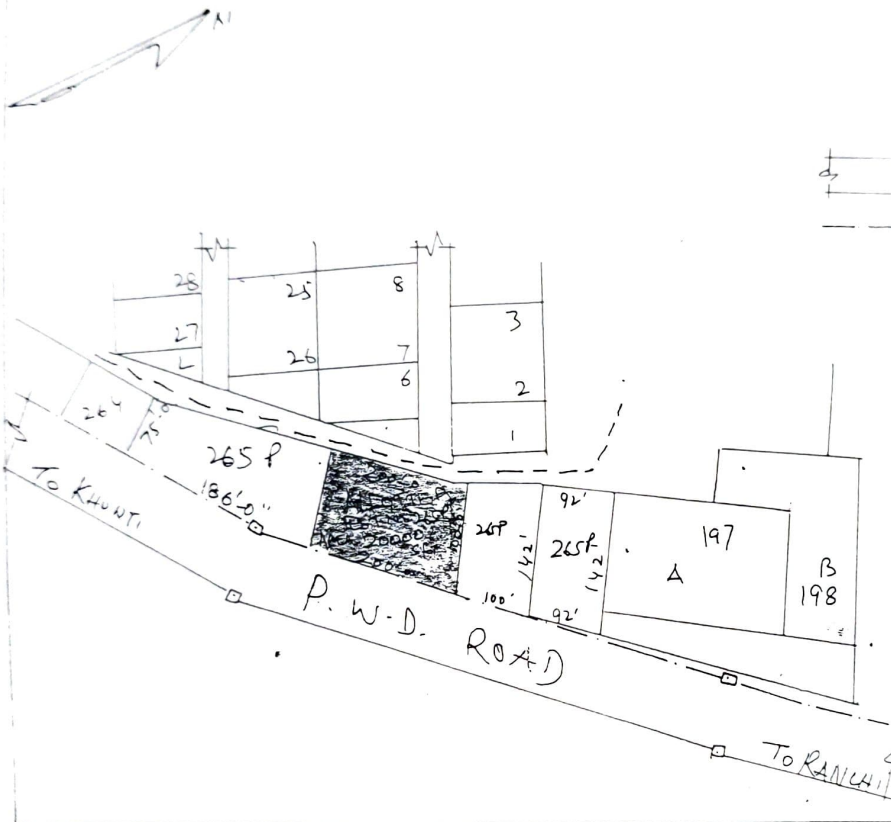

REFERENCE

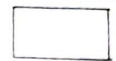

INDUSTRIAL PLOT



ALLOTTED PLOT NO. AREA.



ROAD



INDUSTRIAL BOUNDARY

SCALE: 1"=165'-0"

RANCHI INDUSTRIAL AREA DEVELOPMENT AUTHORITY

LAND POSSESSION MAP

TAKEN OVER	HANDED OVER
<p>for Pradhan (Brothers) P.L.D.</p> <p>S.K. Pradhan</p> <p>M/S MODERN LEAF PRODUCTS</p>	<p>I.E.O</p> <p>R.I.A.D.A. RIADA</p> <p>DA. DEV OFFICER</p>
<p>SURVEYOR: R. S. Ghosh</p>	