


Seller ÷ Sri Suresh Prasad Sharma s/o. Late Gajadhar Sharma
 of G. No ÷ SK-4/59, P.S ÷ Sindri, Dist ÷ Dhanbad

Purchaser ÷ Sri Prabhakar Kumar Singh s/o. Sri Chakradhar Prasad Singh of G. No ÷ B/12, Jagjivan Nager, P.S ÷ Saraidhela, Dist ÷ Dhanbad.

Schedule ÷ Mouza ÷ Amaghata Aalais Sugiadli, No ÷ 9, Khata No ÷ 3, Plot No ÷ 121, (P) Area ÷ 5 Katha.


Boundary ÷ North ÷ 20'-0" wide Road.
 South ÷ part of same plot.
 East ÷ part of same plot.
 West ÷ 10'-0" wide Road.

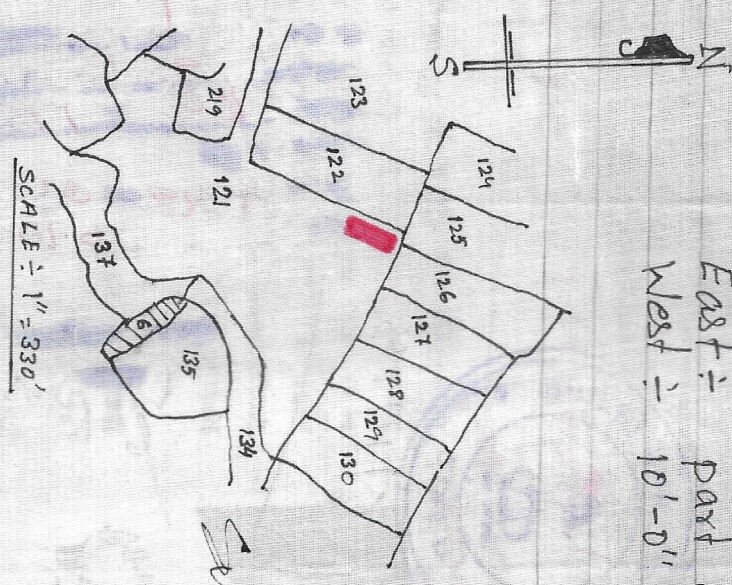

SCALE ÷ 1" = 330'

Swarni 8d.
 6110105
 Shewari

Shown in Red.

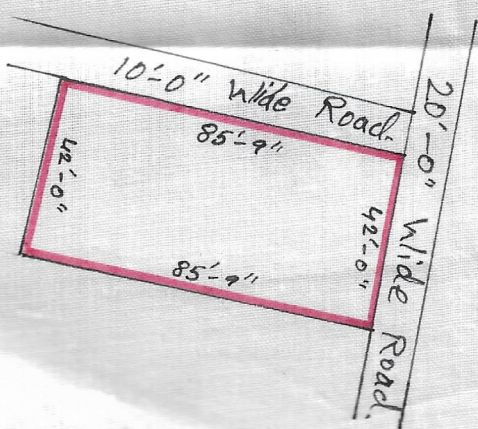

TRACED BY ÷ (Mangy) Yadav

NOT TO SCALE